

SITE PLAN
All features shown are existing.

THESE PLANS WERE CONSTRUCTED USING THE 1987 ACHITECTURAL PERMIT PLANS and ON SITE REVIEW CONFIRMING FEATURES AS NOTED BELOW ARE GENERALLY IN THE LOCATIONS SHOWN.


SITE PLAN:
BUILDING FOOTPRINT, PARKING AREAS, DRIVEWAYS, WALKWAYS AND LANDSCAPE AREA.

BUILDING PLANS:
WALLS, DOORS and WINDOWS.

AS BUILT MEASUREMENTS WERE NOT MADE.

- DRAWING LIST
- 1. EXISTING SITE PLAN
 - 2. EXISTING BASEMENT PLAN
 - 3. EXISTING GROUND FLOOR PLAN
 - 4. EXISTING SECOND FLOOR PLAN
 - 5. CONCEPT BED LAYOUT

Bruce MacNeill Architect 221 Queen Street, Cobourg, Ontario tel/ fax 905-377-1087 <small>THIS DRAWING IS NOT TO BE USED FOR CONSTRUCTION UNLESS SIGNED. THE DRAWING SHALL BE VOID OF ANY SIGNATURE OR SEAL. NO PART OF THIS WORK DISCREPANCIES FOUND PRIOR TO PROCEEDING WITH THE WORK.</small>	CANADIAN CENTRE FOR ADDICTIONS		Printed- 9/3/2020
	client	AS BUILT SITE and FLOOR PLANS 420 Division Street, Cobourg	Sept 3, 2020, As Built Drawings with Concept Bed Layouts, 24x18 May 13, 2020, As Built Drawings with Concept Bed Layouts April 30, 2020, As Built Drawings for Owner/Planner Comment
	project	EXISTING SITE PLAN	Issued: date scale dwg. no.
			April 2020 1:250 1

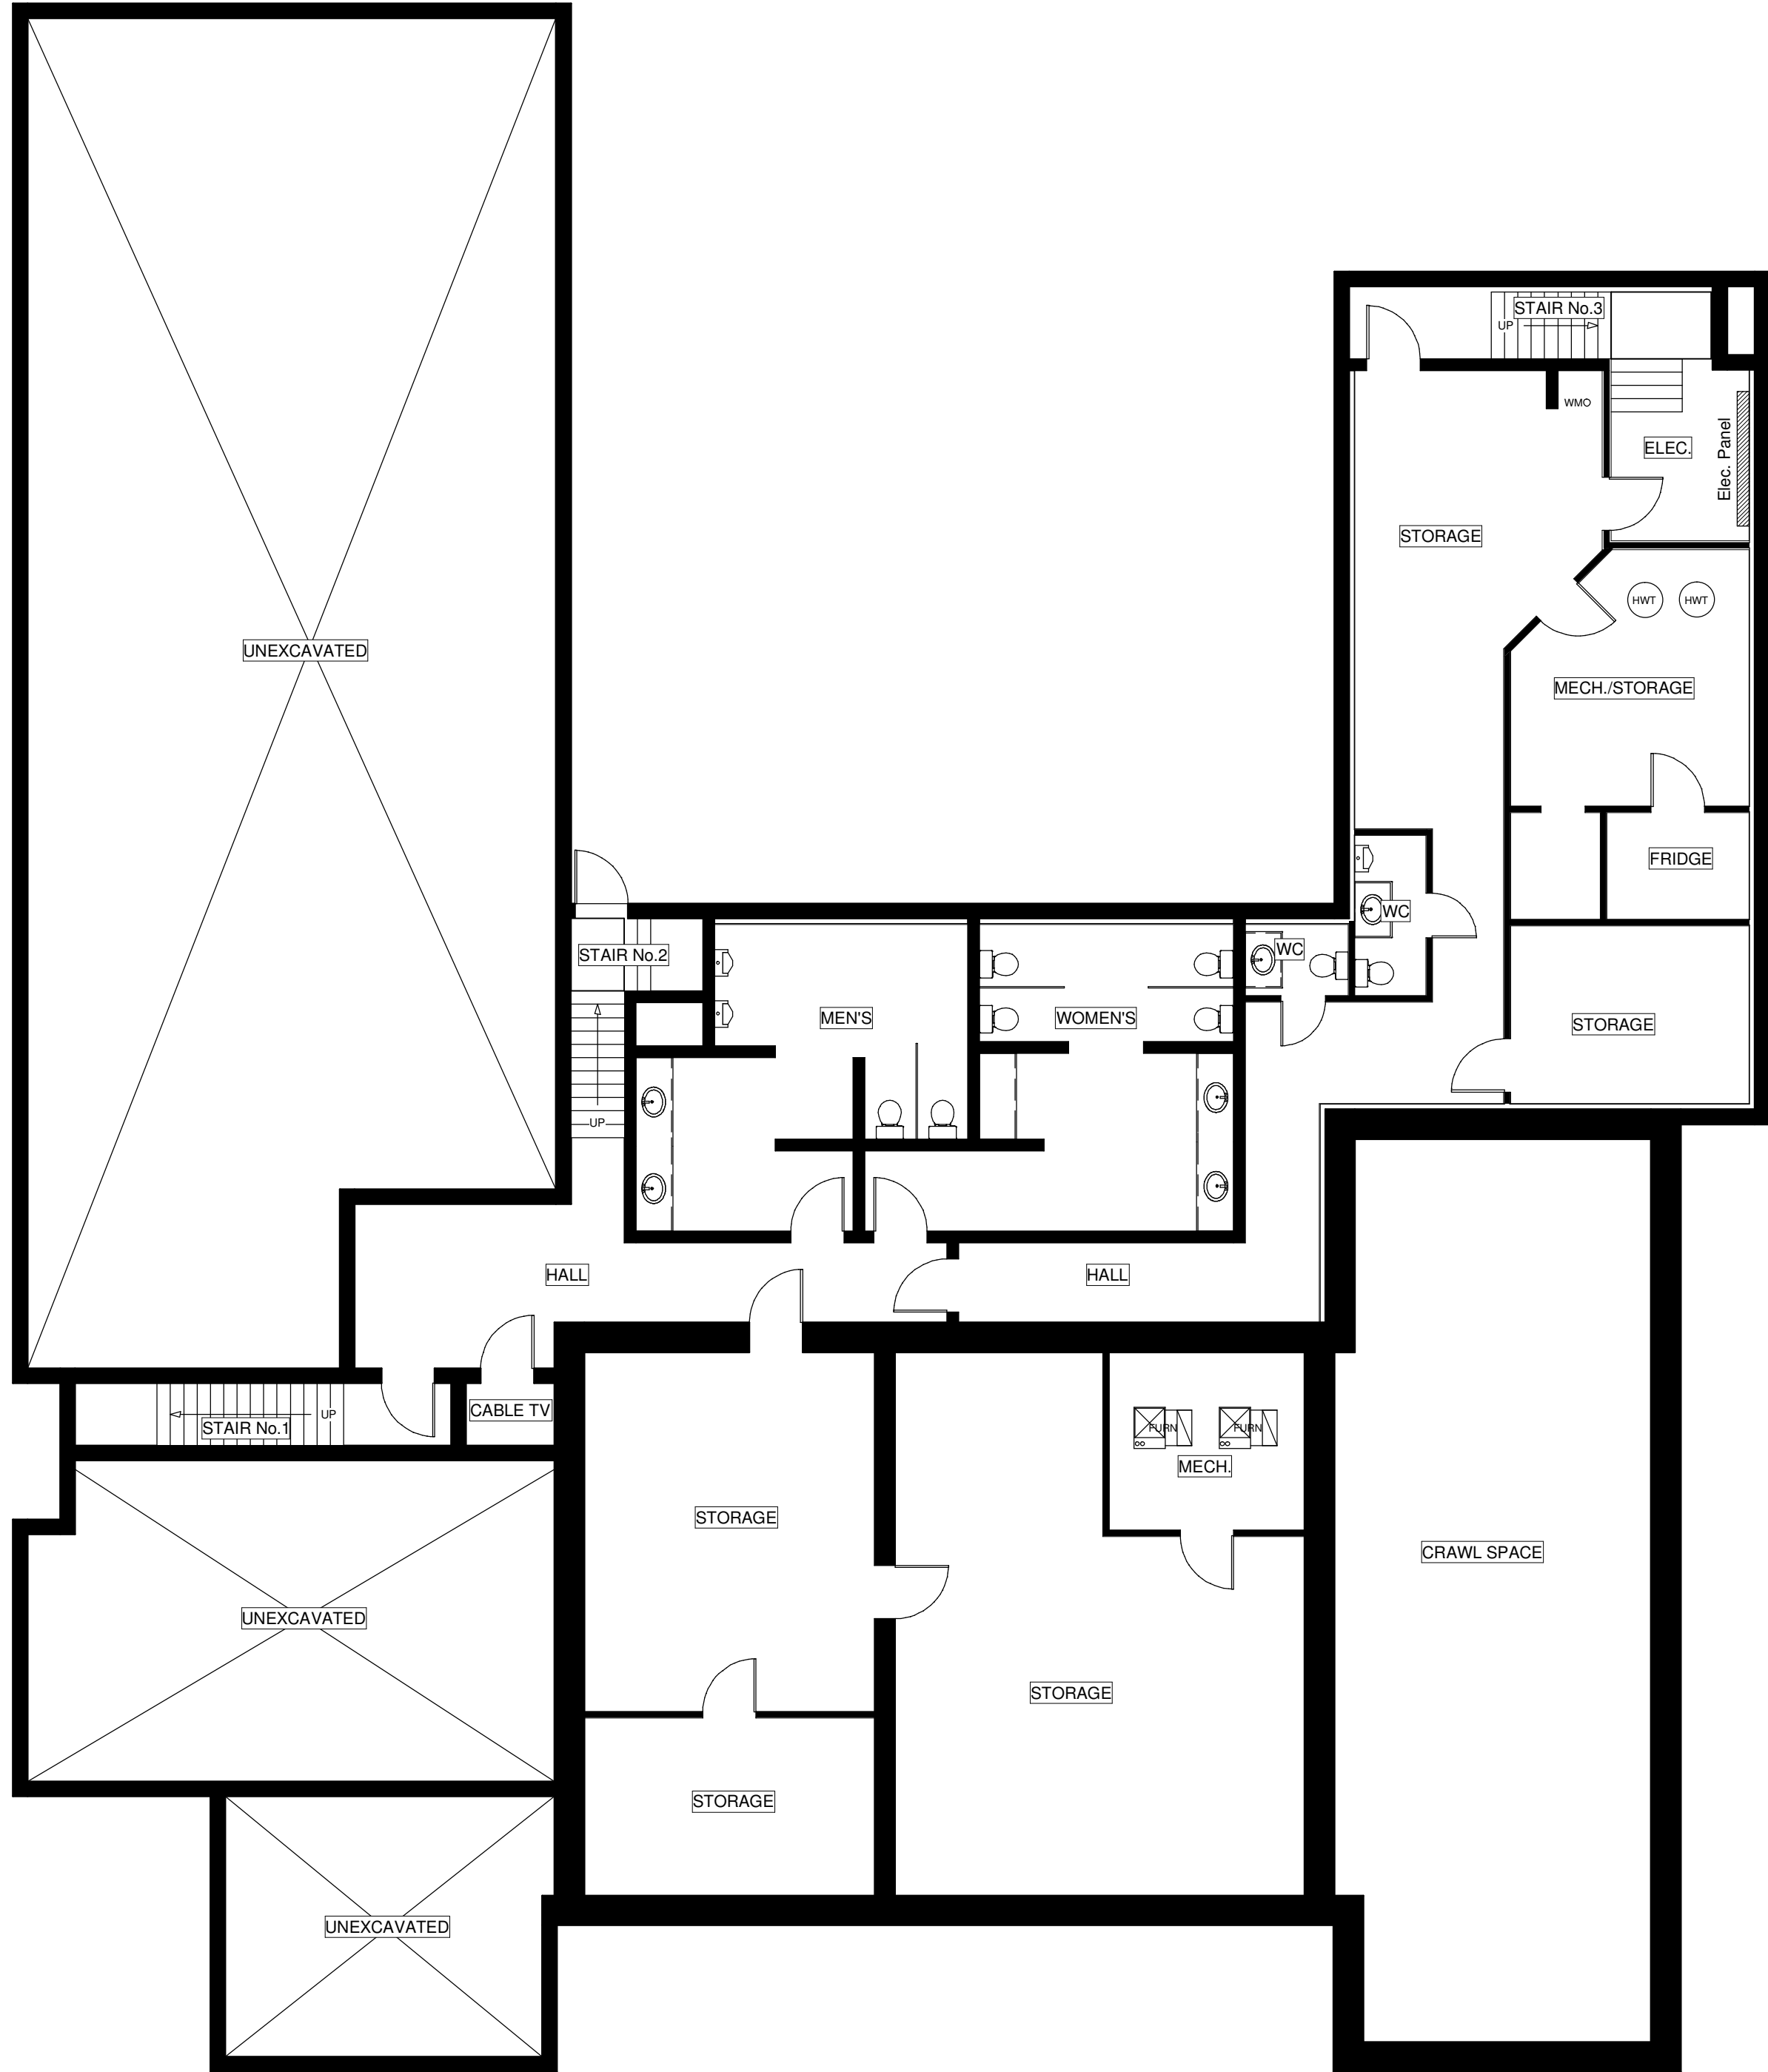

BASEMENT PLAN


THESE PLANS WERE CONSTRUCTED USING THE 1987 ACHITECTURAL PERMIT PLANS and ON SITE REVIEW CONFIRMING FEATURES AS NOTED BELOW ARE GENERALLY IN THE LOCATIONS SHOWN.

SITE PLAN:
BUILDING FOOTPRINT, PARKING AREAS, DRIVEWAYS, WALKWAYS AND LANDSCAPE AREA.

BUILDING PLANS:
WALLS, DOORS and WINDOWS.

AS BUILT MEASUREMENTS WERE NOT MADE.

Bruce MacNeill Architect 221 Queen Street, Cobourg, Ontario tel/ fax 905-377-1087 <small>THIS DRAWING IS NOT TO BE USED FOR CONSTRUCTION UNLESS SIGNED. THE DRAWING IS A SHARED RESPONSIBILITY AND THE ARCHITECT SHALL BE RESPONSIBLE FOR ANY DISCREPANCIES FOUND PRIOR TO PROCEEDING WITH THE WORK.</small>	CANADIAN CENTRE FOR ADDICTIONS		Printed- 9/3/2020	
	client	AS BUILT SITE and FLOOR PLANS 420 Division Street, Cobourg	Sept 3, 2020, As Built Drawings with Concept Bed Layouts, 24x18 May 13, 2020, As Built Drawings with Concept Bed Layouts April 30, 2020, As Built Drawings for Owner/Planner Comment	
	project	EXISTING BASEMENT PLAN	date April 2020	dwg. no. 2

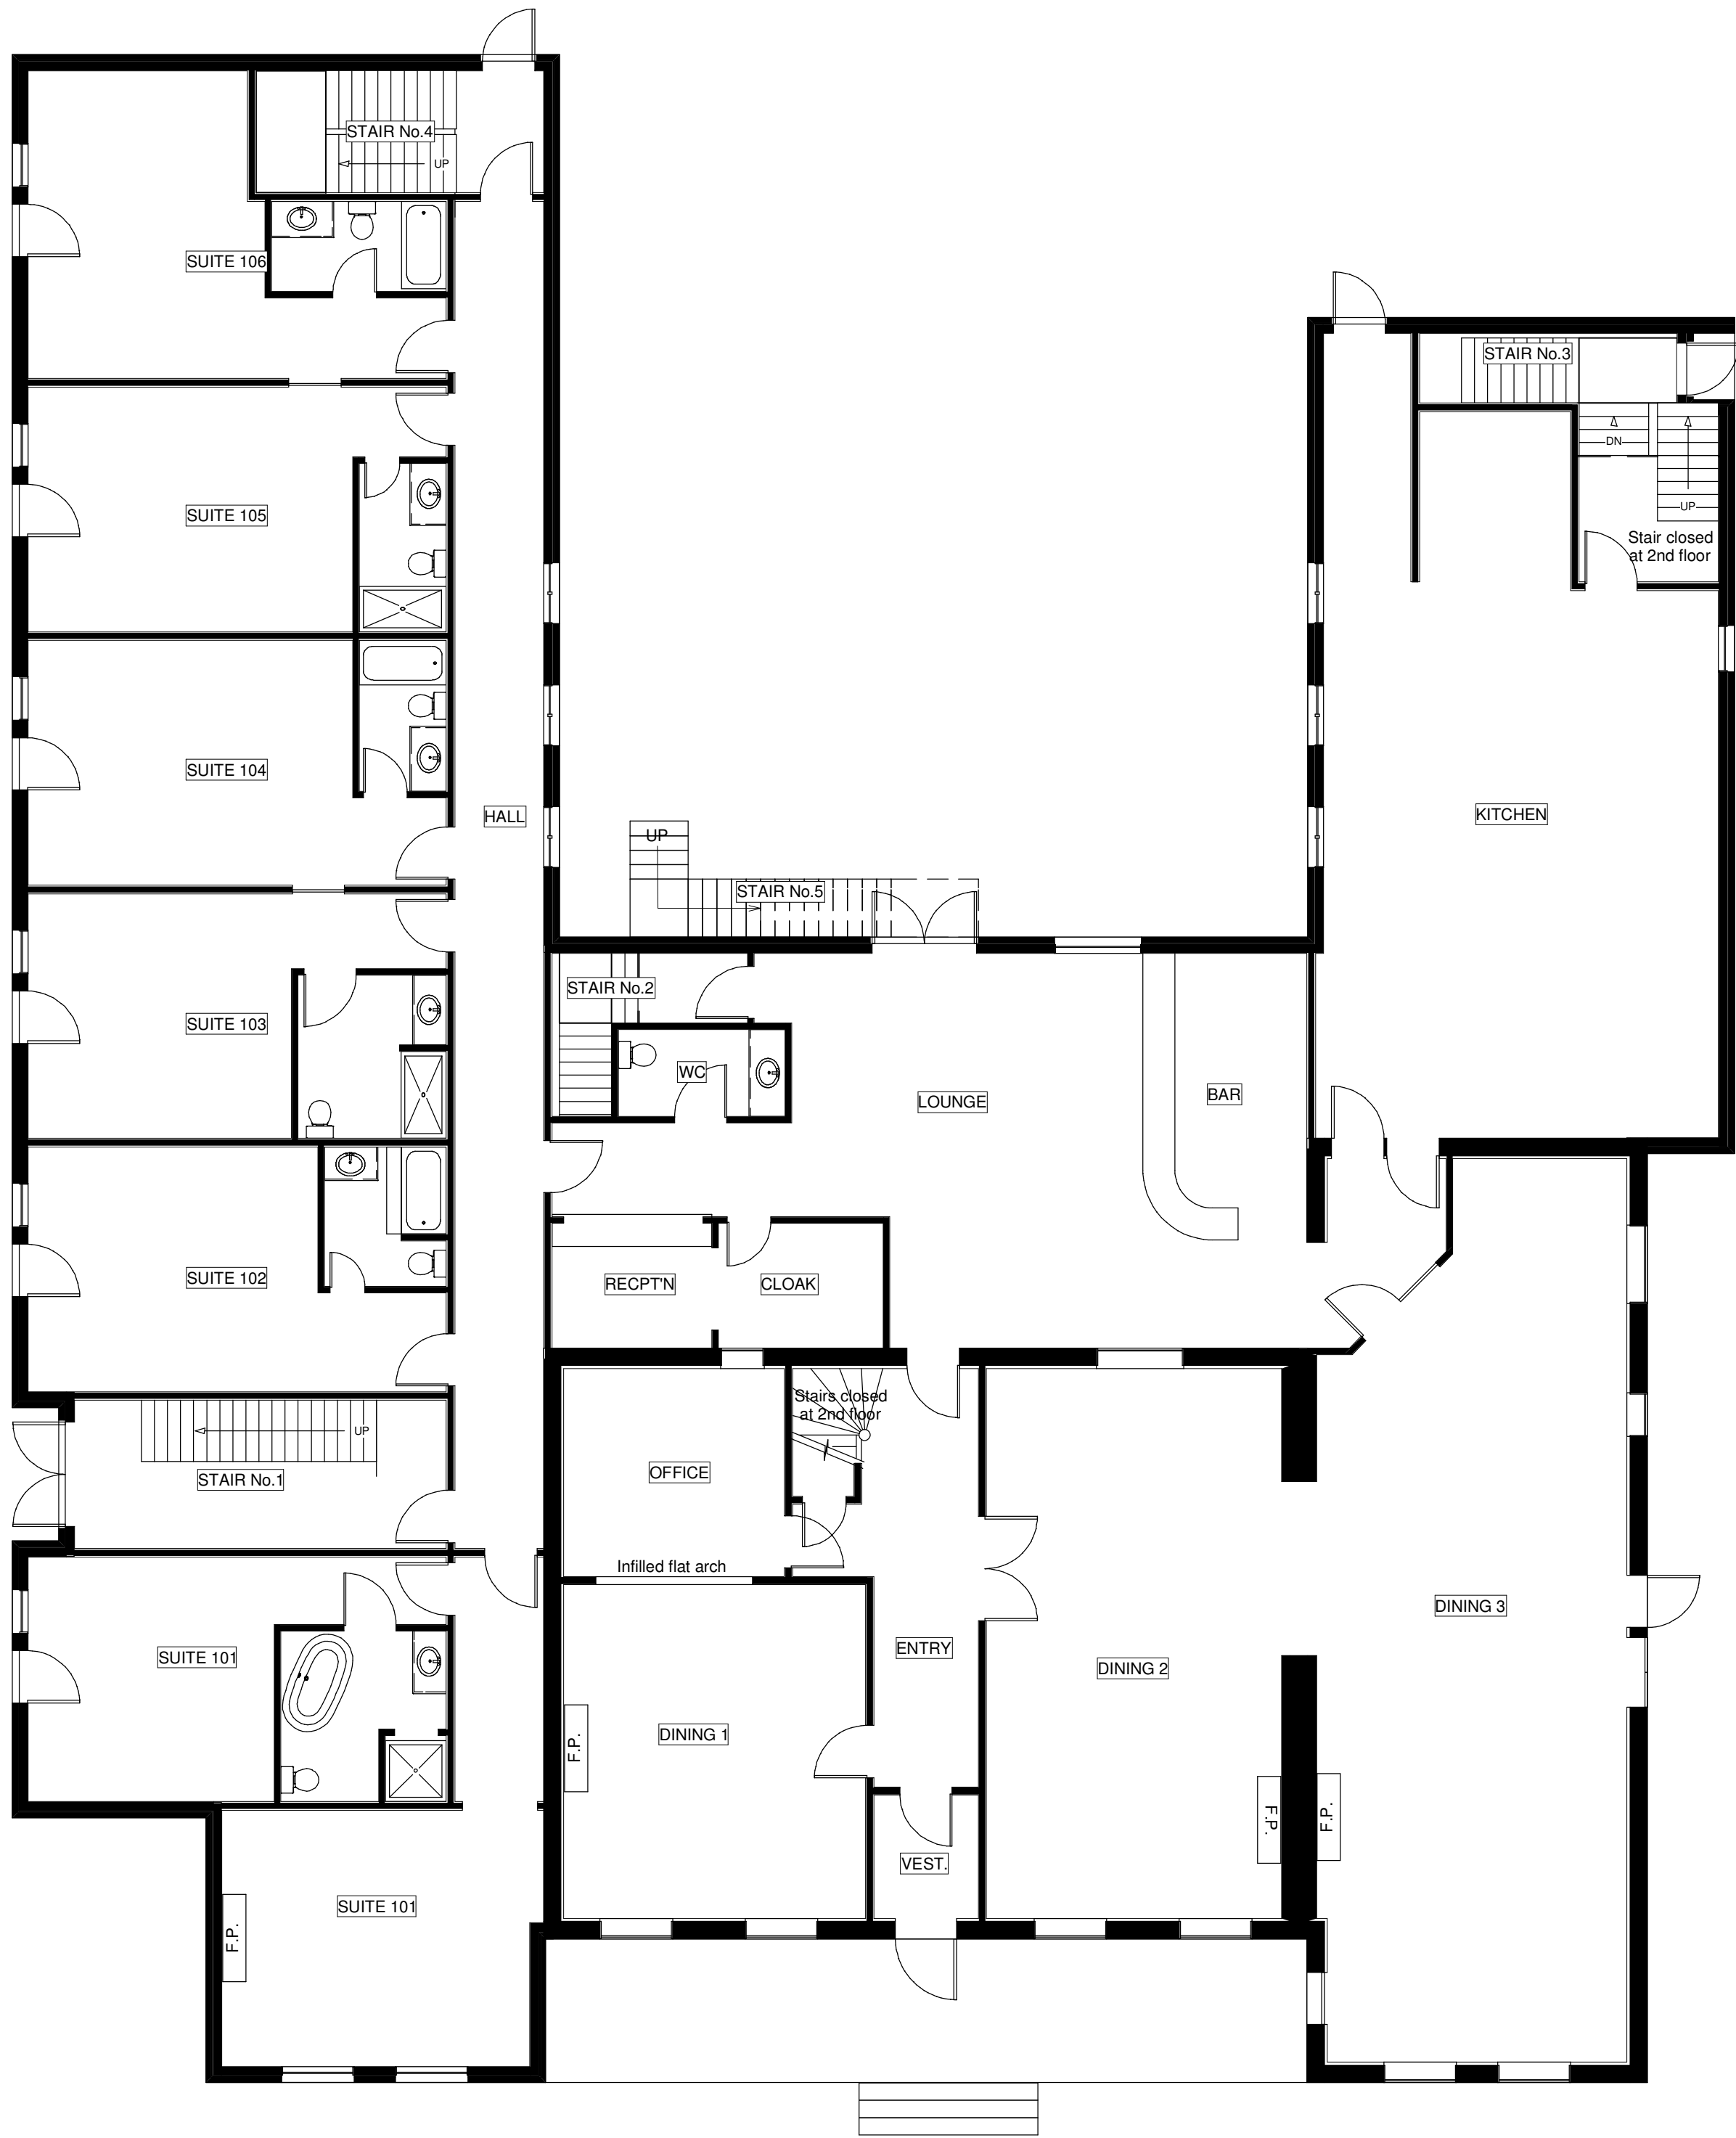

GROUND FLOOR PLAN

THESE PLANS WERE CONSTRUCTED USING THE 1987 ACHITECTURAL PERMIT PLANS and ON SITE REVIEW CONFIRMING FEATURES AS NOTED BELOW ARE GENERALLY IN THE LOCATIONS SHOWN.

SITE PLAN:
BUILDING FOOTPRINT, PARKING AREAS, DRIVEWAYS, WALKWAYS AND LANDSCAPE AREA.

BUILDING PLANS:
WALLS, DOORS and WINDOWS.

AS BUILT MEASUREMENTS WERE NOT MADE.

Bruce MacNeill Architect 221 Queen Street, Cobourg, Ontario tel/ fax 905-377-1087 <small>THIS DRAWING IS NOT TO BE USED FOR CONSTRUCTION UNLESS SIGNED. THE DRAWING SHALL BE USED AS A REFERENCE ONLY. NO RESPONSIBILITY FOR ANY DISCREPANCIES FOUND PRIOR TO PROCEEDING WITH THE WORK.</small>	client CANADIAN CENTRE FOR ADDICTIONS project AS BUILT SITE and FLOOR PLANS 420 Division Street, Cobourg dwg. title EXISTING GROUND FLOOR PLAN	Printed- 9/3/2020	
		issued: Sept 3, 2020, As Built Drawings with Concept Bed Layouts, 24x18 May 13, 2020, As Built Drawings with Concept Bed Layouts April 30, 2020, As Built Drawings for Owner/Planner Comment	date April 2020
		scale 1/8" = 1'-0"	dwg. no. 3



SECOND FLOOR PLAN

THESE PLANS WERE CONSTRUCTED USING THE 1987 ACHITECTURAL PERMIT PLANS and ON SITE REVIEW COMFIRMING FEATURES AS NOTED BELOW ARE GENERALLY IN THE LOCATIONS SHOWN.

SITE PLAN:
BUILDING FOOTPRINT, PARKING AREAS, DRIVEWAYS, WALKWAYS AND LANDSCAPE AREA.

BUILDING PLANS:
WALLS, DOORS and WINDOWS.


AS BUILT MEASUREMENTS WERE NOT MADE.

Bruce MacNeill Architect 221 Queen Street, Cobourg, Ontario tel/ fax 905-377-1087 <small>THIS DRAWING IS NOT TO BE USED FOR CONSTRUCTION UNLESS SIGNED. THE DRAWING SHALL BE USED AS A REFERENCE ONLY. THE ARCHITECT SHALL BE RESPONSIBLE FOR ANY DISCREPANCIES FOUND PRIOR TO PROCEEDING WITH THE WORK.</small>	CANADIAN CENTRE FOR ADDICTIONS		Printed- 9/3/2020	
	client	AS BUILT SITE and FLOOR PLANS 420 Division Street, Cobourg	Sept 3, 2020, As Built Drawings with Concept Bed Layouts, 24x18 May 13, 2020, As Built Drawings with Concept Bed Layouts April 30, 2020, As Built Drawings for Owner/Planner Comment	
	project	EXISTING SECOND FLOOR PLAN	date April 2020	dwg. no. 1/8" = 1'-0" 4



14 'Double' Size Beds this floor

GROUND FLOOR

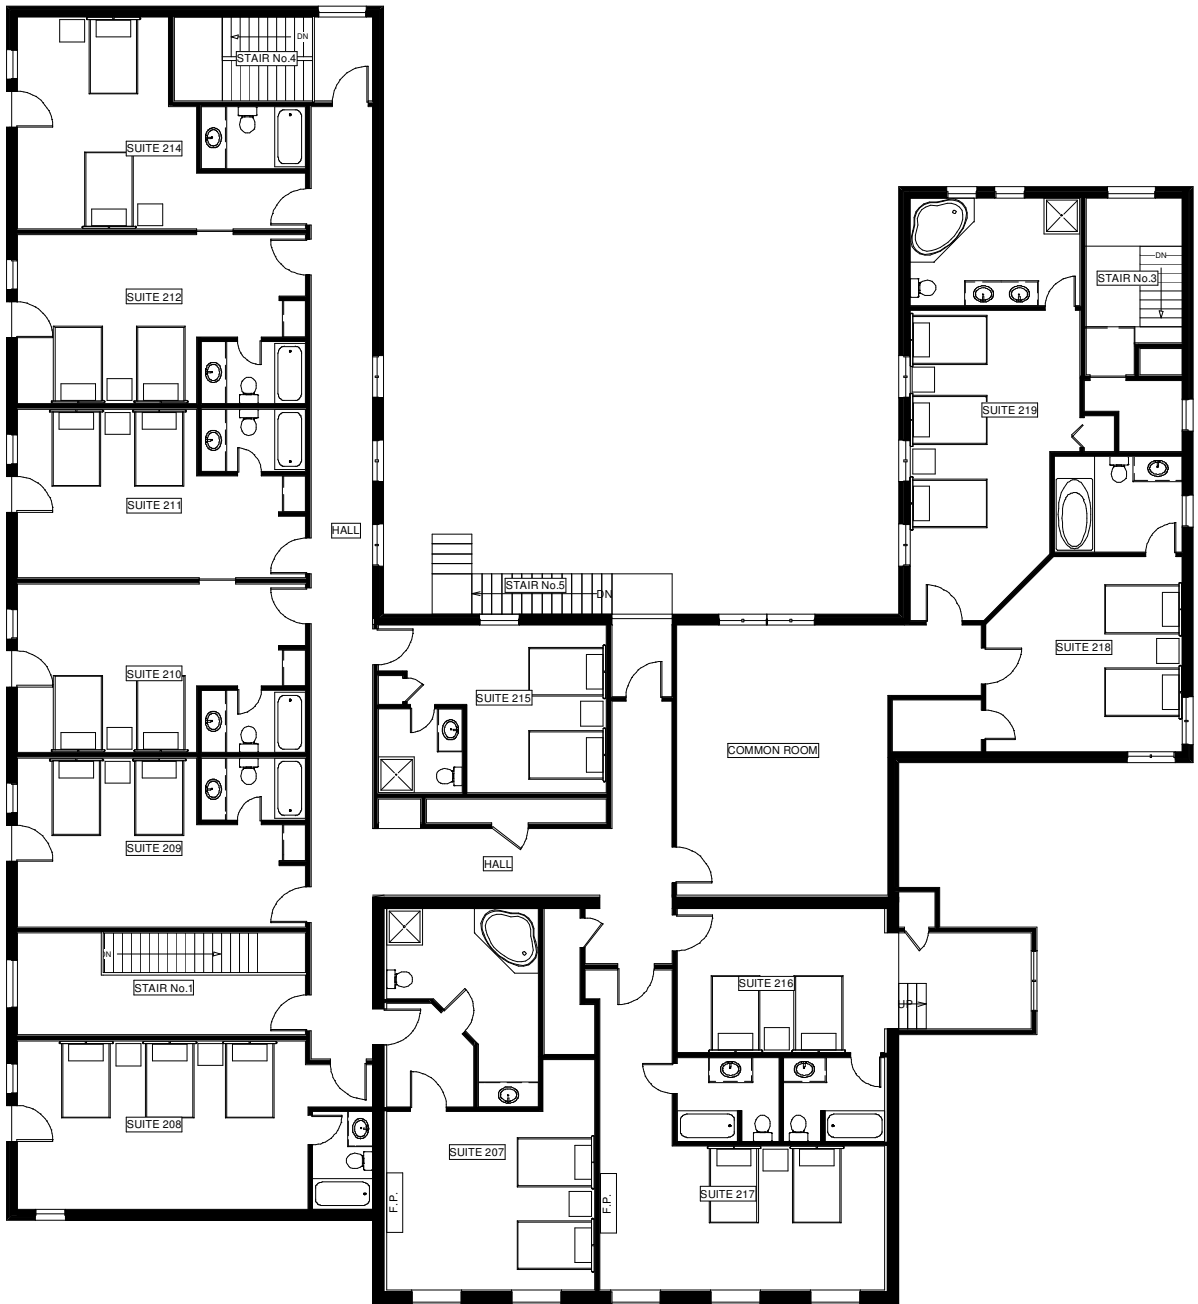

26 'Double' Size Beds this floor

SECOND FLOOR

Total of 40 Beds Proposed

THESE PLANS WERE CONSTRUCTED USING THE 1987 ACHITECTURAL PERMIT PLANS and ON SITE REVIEW CONFIRMING FEATURES AS NOTED BELOW ARE GENERALLY IN THE LOCATIONS SHOWN.

SITE PLAN:
BUILDING FOOTPRINT, PARKING AREAS, DRIVEWAYS, WALKWAYS AND LANDSCAPE AREA.

BUILDING PLANS:
WALLS, DOORS and WINDOWS.

AS BUILT MEASUREMENTS WERE NOT MADE.

Bruce MacNeill Architect 221 Queen Street, Cobourg, Ontario tel/ fax 905-377-1087 <small>THIS DRAWING IS NOT TO BE USED FOR CONSTRUCTION UNLESS SIGNED. THE DRAWING FURNISHED SHALL BE THE DESIGNER'S RESPONSIBILITY. ANY DISCREPANCIES FOUND PRIOR TO PROCEEDING WITH THE WORK.</small>	client CANADIAN CENTRE FOR ADDICTIONS project AS BUILT SITE and FLOOR PLANS 420 Division Street, Cobourg dwg. title CONCEPT BED LAYOUT	Printed- 9/3/2020		
		Sept 3, 2020, As Built Drawings with Concept Bed Layouts, 24x18 May 13, 2020, As Built Drawings with Concept Bed Layouts April 30, 2020, As Built Drawings for Owner/Planner Comment	issued:	5
		date April 2020 scale 1/16" = 1'-0"	dwg. no.	